

General tolerances (Unless otherwise noted):


Whole:	± 1.0 mm
Decimal:	± 0.5 mm
Angular:	± 0.5 deg.

Break ALL sharp corners and remove burrs & swarf.
All machining and fabrication to meet MIL-STD-1111.
All dimensions in mm unless otherwise noted.
Third Angle Projection - AS 1100

issue	amendment	date
AB	AS BUILT	22.06.11

I

- | |
|--|
| PIPE 1 - DELIVERY PUMPS TO SLUDGE TANK |
| PIPE 2 - PT TANK TO BIOLOGY TANK |
| PIPE 3 - MEMBRANE TO BIOLOGY & SLUDGE TANK |
| PIPE 4 - RO UNITS TO SLUDGE & FILTRATE TANK |
| PIPE 5 - DELIVERY PUMPS TO NPOW TANK |
| PIPE 6 - DELIVERY PUMPS TO CTMT |
| PIPE 7 - FILTRATE TO UV TO RO UNITS |
| PIPE 9 - RO UNITS TO CHLORINE CONTACT, CHLORINE DOSING & FILTRATE TANK |
| PIPE 10 - BIOLOGY TO MEMBRANE TANKS |
| PIPE 11 - MEMBRANE TANKS TO FILTRATE TANK |
| PIPE 12 - CHLORINE CONTACT TO DELIVERY PUMPS |
| PIPE 15 - PT TANK TO SLUDGE TANK |
| PIPE OF1 - OVERFLOW FROM BIOLOGY & MEMBRANE TANKS |
| PIPE OF2 - OVERFLOW FROM MEMBRANE |
| PIPE OF3 - OVERFLOW FROM FILTRATE TANK |
| PIPE OF4 - OVERFLOW FROM CHLORINE CONTACT TANK |
| PIPE S1 - BOOF SEWER TO SLUDGE TANK |
| PIPE S2 - BUILDING SEWER TO PT SIEVE |
| PIPE S3 - SLUDGE TANK TO BUILDING SEWER |
| VENT PIPE - PT AND SLUDGE TANK VENT PIPE |

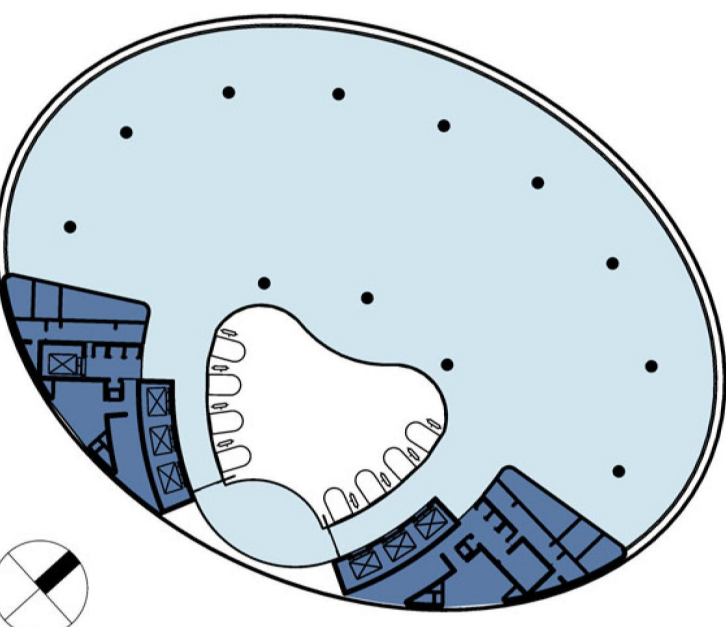

Clearwater Technology



1/26 Megalong Street, Katoomba NSW 2780 Australia
PO Box 7091, Leura NSW 2780 Australia
T +61 2 4782 3300
F +61 2 4782 3211
www.clearwatertechnology.com.au

DEXUS principal	Level 9 343 George Street Sydney NSW 2000
GROCON d & c contractor	152 Gloucester Street Sydney NSW 2000
Architectus Sydney architects	Level 3 341 George Street Sydney NSW 2000
Ingenhoven Architekten GmbH architects	Plange Mühle 1 D-40221 Düsseldorf Germany

project

1 BLIGH STREET, SYDNEY

drawing

BASEMENT 3 FLOOR PLAN

scale 1 : 100 drawing no.

drawn TF **WTS01-002**

checked	NE	issue
---------	----	-------

project no **AB**

AS BUILT

